



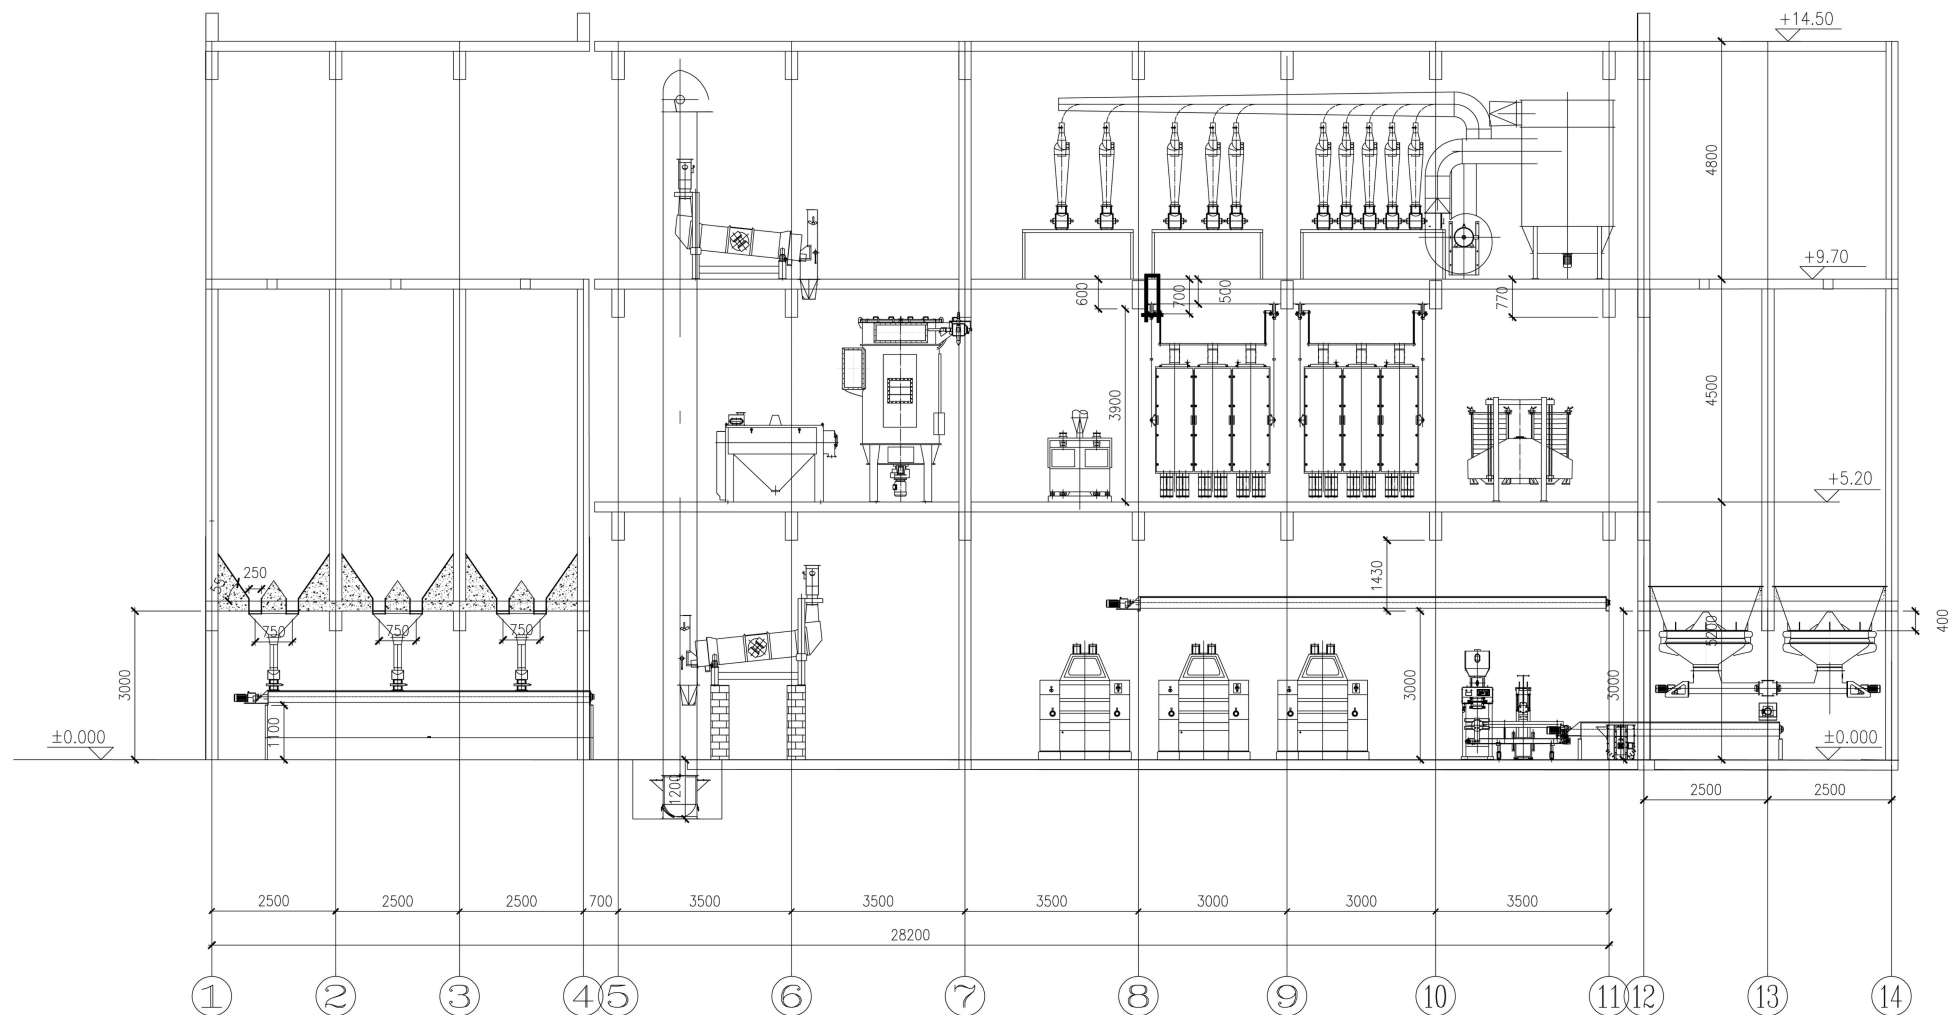

Longitudinal Section Drawing
of Workshop_Wheat Cleaning
Flour Milling & Flour Packing
and Storage

Iran 100T Wheat Mill


Hebei Pingle Flour Machinery
Co., Ltd

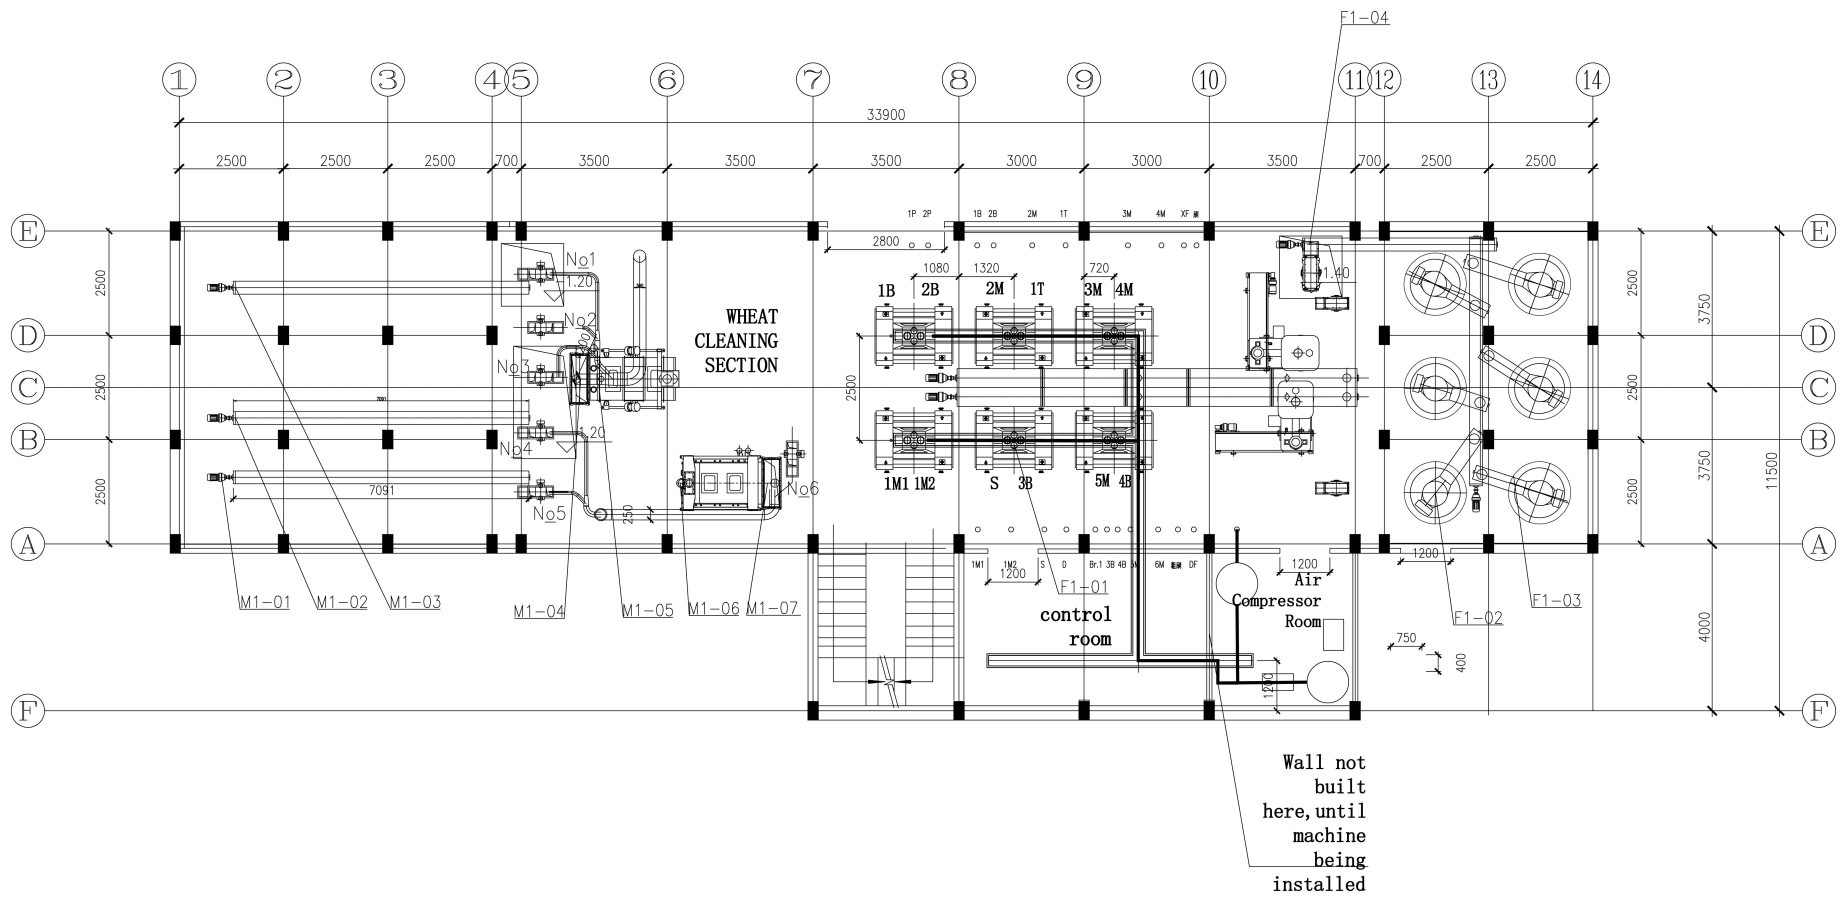


CODE	Equipment	Model	QTY	Remark
M1-01	Screw conveyor	TLSS200	1	silo output_ secondary wheat tempering
M1-02	Screw conveyor	TLSS200	1	silo output_ first wheat tempering
M1-03	Screw conveyor	TLSS200	1	silo output_ dirty wheat
M1-04	Air Channel	XFDE100	1	
M1-05	Vibro Separator	TQLZ100*150		Preliminary cleaning weight 426kg
M1-06	Rotary Separator	TQLM100	1	Wheat Cleaning Weight 720kg
M1-07	Air Channel	XFDE100	1	

Code	Equipment	Model	QTY	Remark
F1-01	ROLLER MILL	PLMFKT100*25	6	Unit Weight 3300kg
F1-02	Vibro Discharger	TDXZM160*50	6	
F1-03	Tube Conveyor	GLSS200	6	
F1-04	Screw Conveyor	TLSS250	2	

1st FLOOR LAYOUT	100T WHEAT MILL			
HEBEI PINGLE FLOUR MACHINERY GROUP CO., LTD				

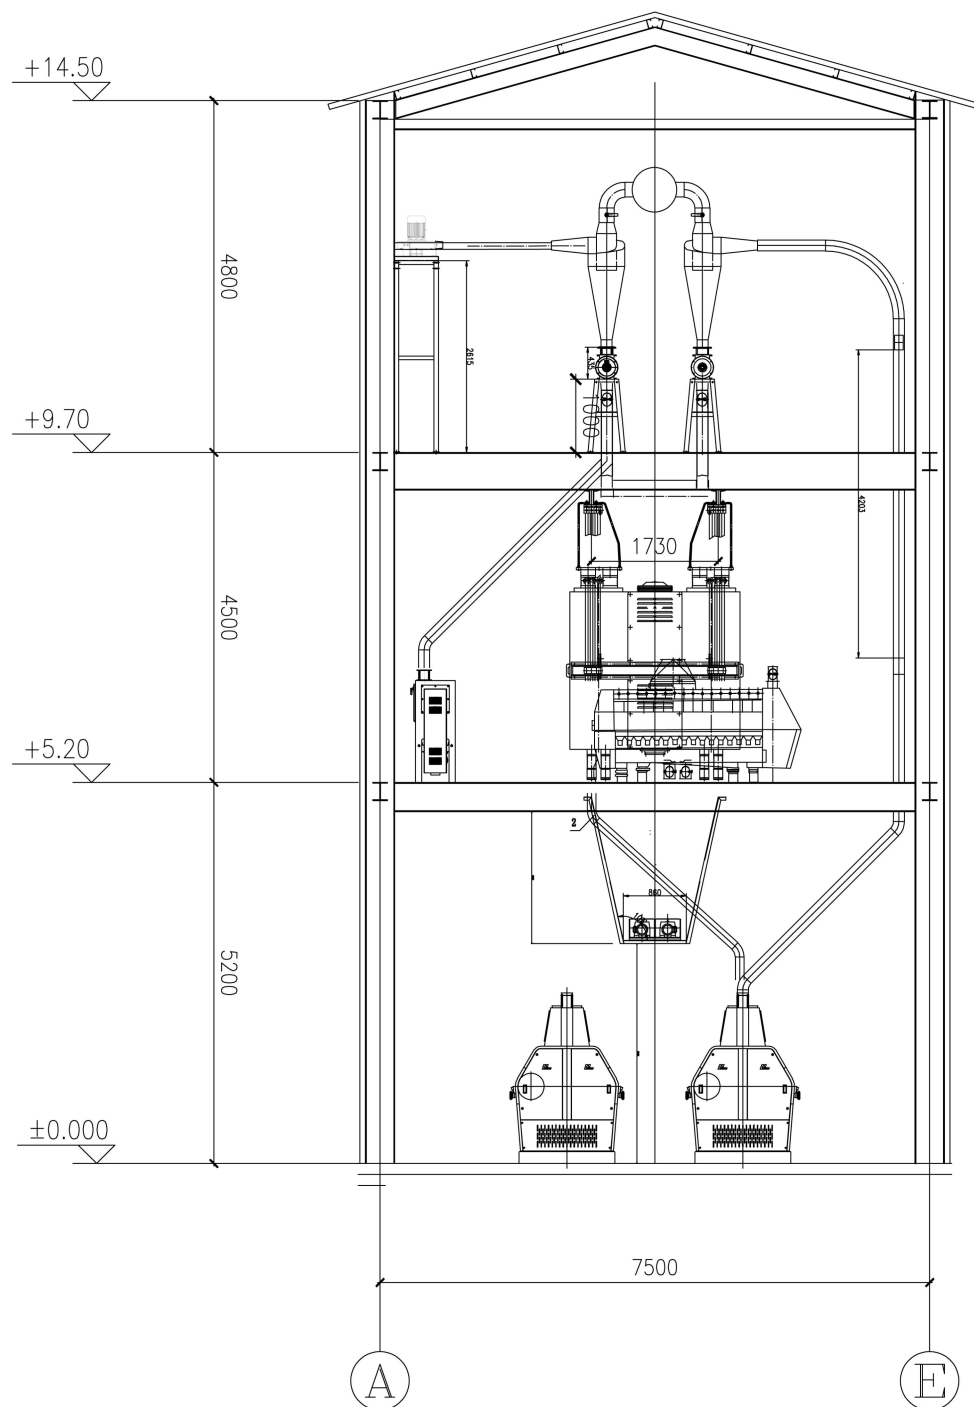

 河北苹乐面粉机械集团有限公司 HEBEI PINGLE FLOUR MACHINERY GROUP CO., LTD				建设单位 Owner Ard Zaren Ferdows		☐ 方案设计阶段	
项目负责人 Principal 刘文波				项目名称 Project Name Iran 100T Wheat Mill		☐ 初步设计阶段	
项目經理 Subprincipal 刘文波				设计 Design 刘文波		☐ 扩初设计阶段	
审定 Authorized By 刘文波				制图 Drawer 刘文波		☐ 施工图设计阶段	
校对 Proofread By 刘文波				日期 Date 2019. 9. 16		图别 Discipline 艺施	图号 Dwg No.
						☒ 竣工图设计阶段	

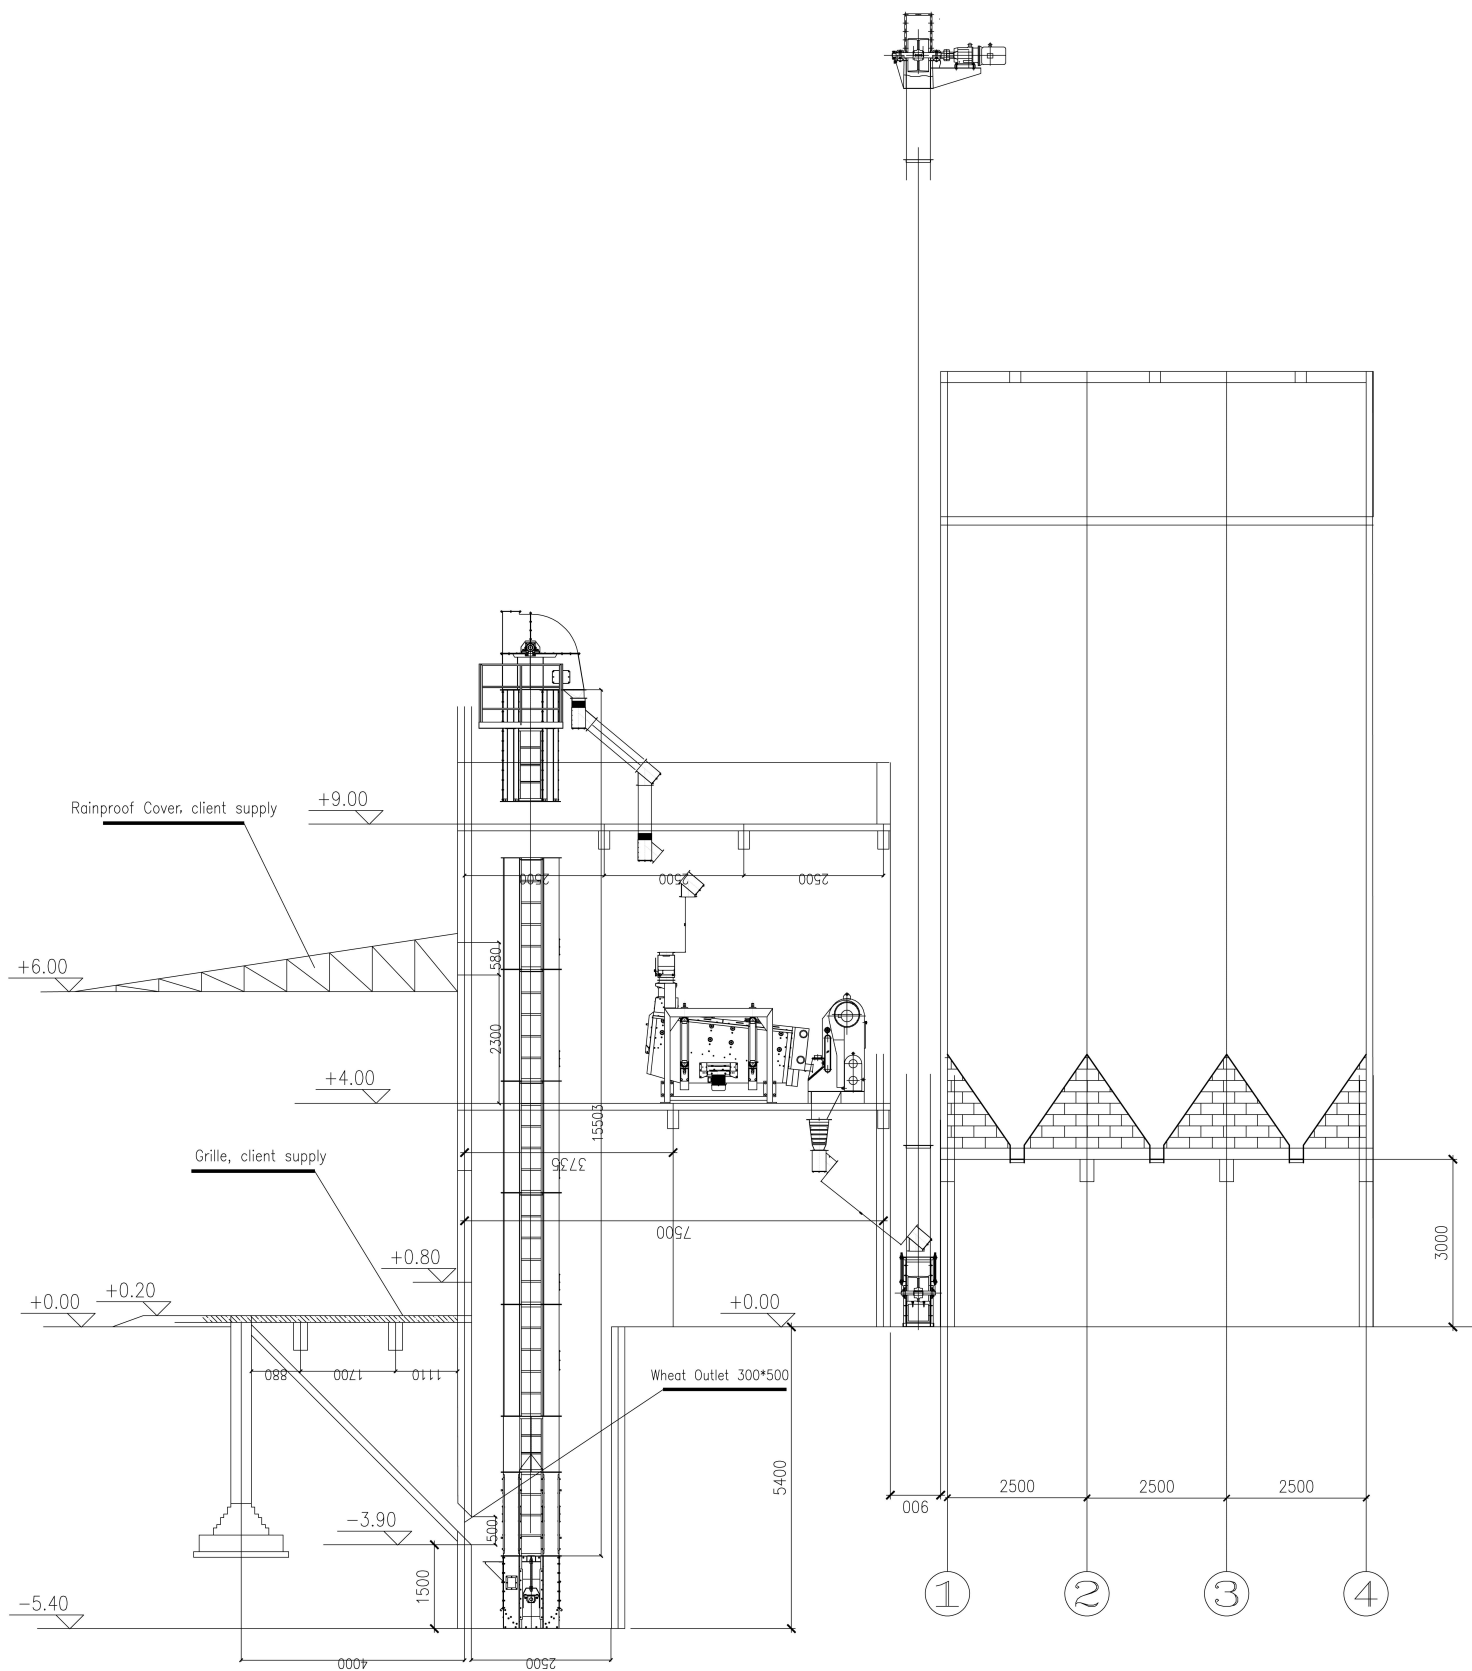

河北苹乐面粉机械集团有限公司
Hebei Pingle Flour Machinery Group Co., Ltd

建设单位 Ard Zarren Ferdows

项目名称 Iran 100T Wheat Mill


设计 马召 审定


制图 马召 工程负责人


校对 工种负责人

Longitudinal Section Drawing
of Workshop Wheat Preliminary
Cleaning & Storage

日期 2016.12 图别 艺施 图号

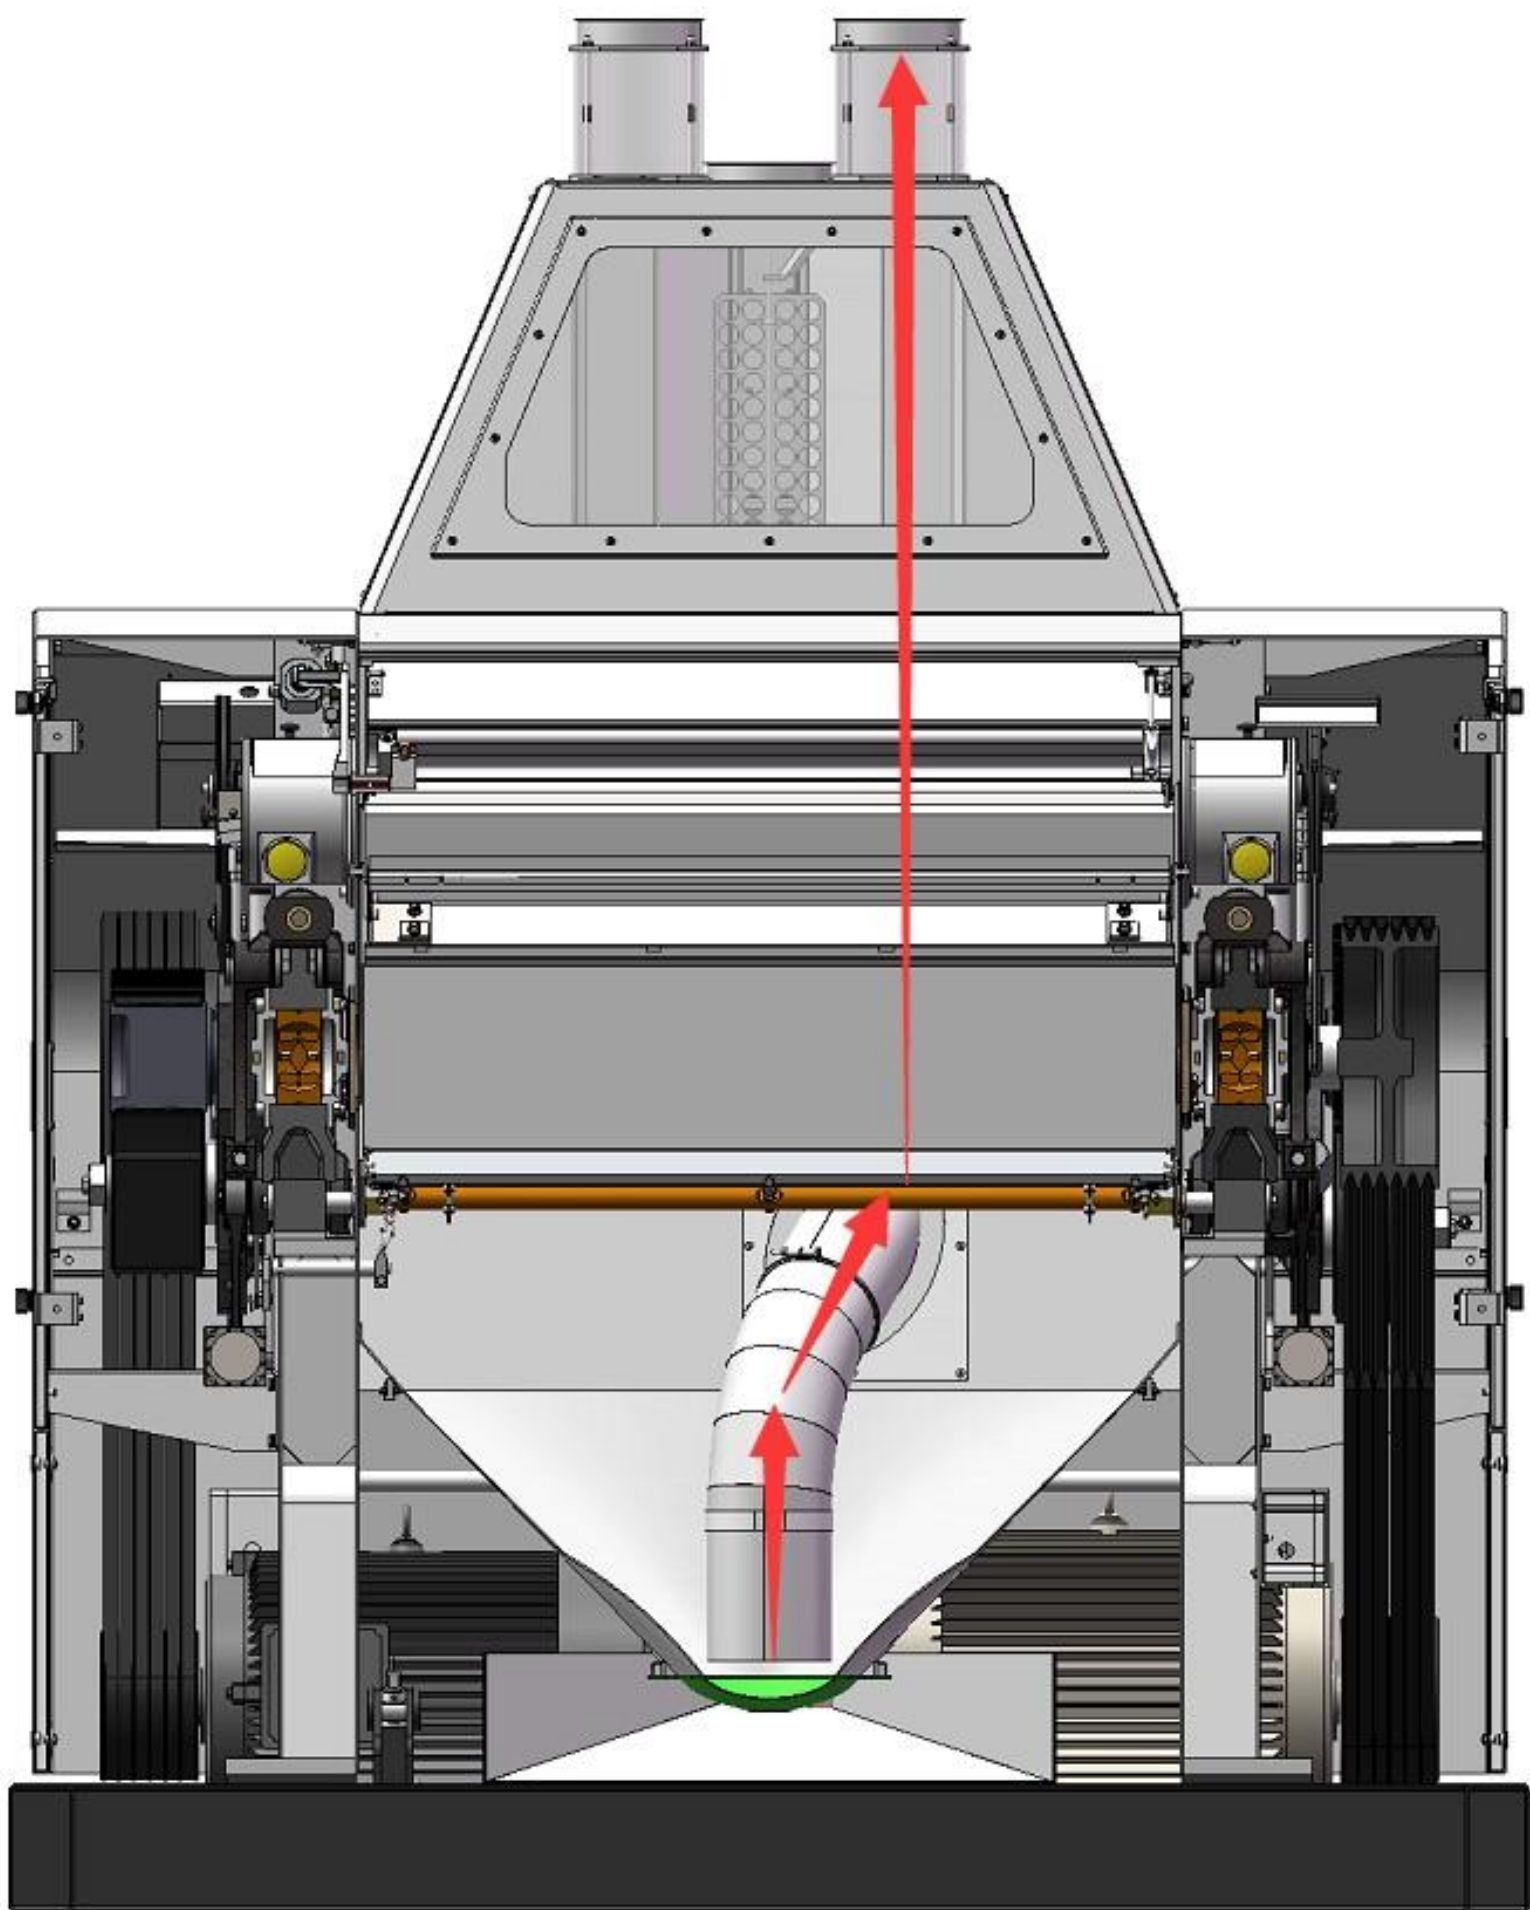

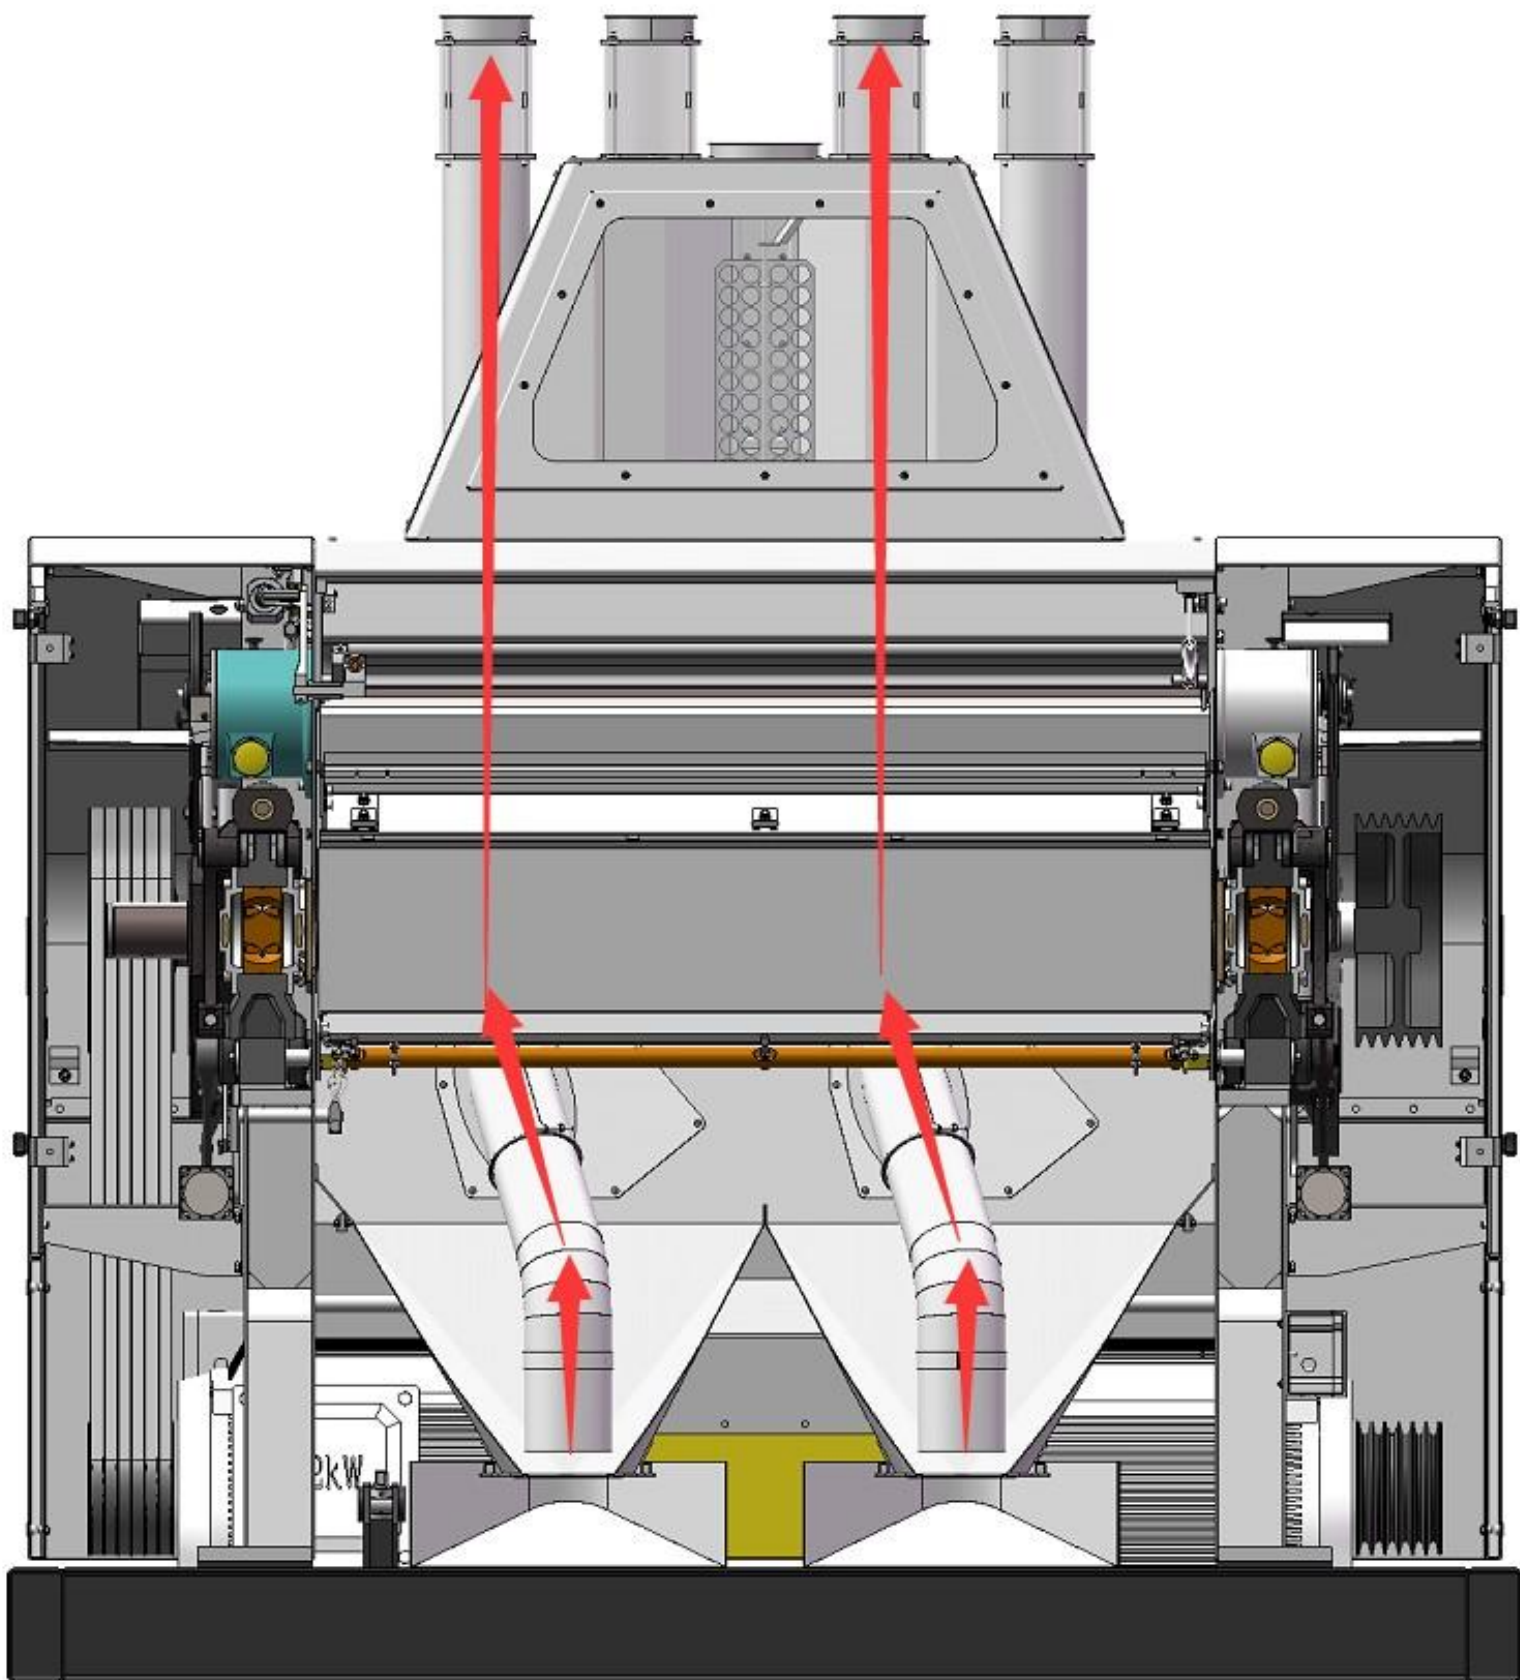

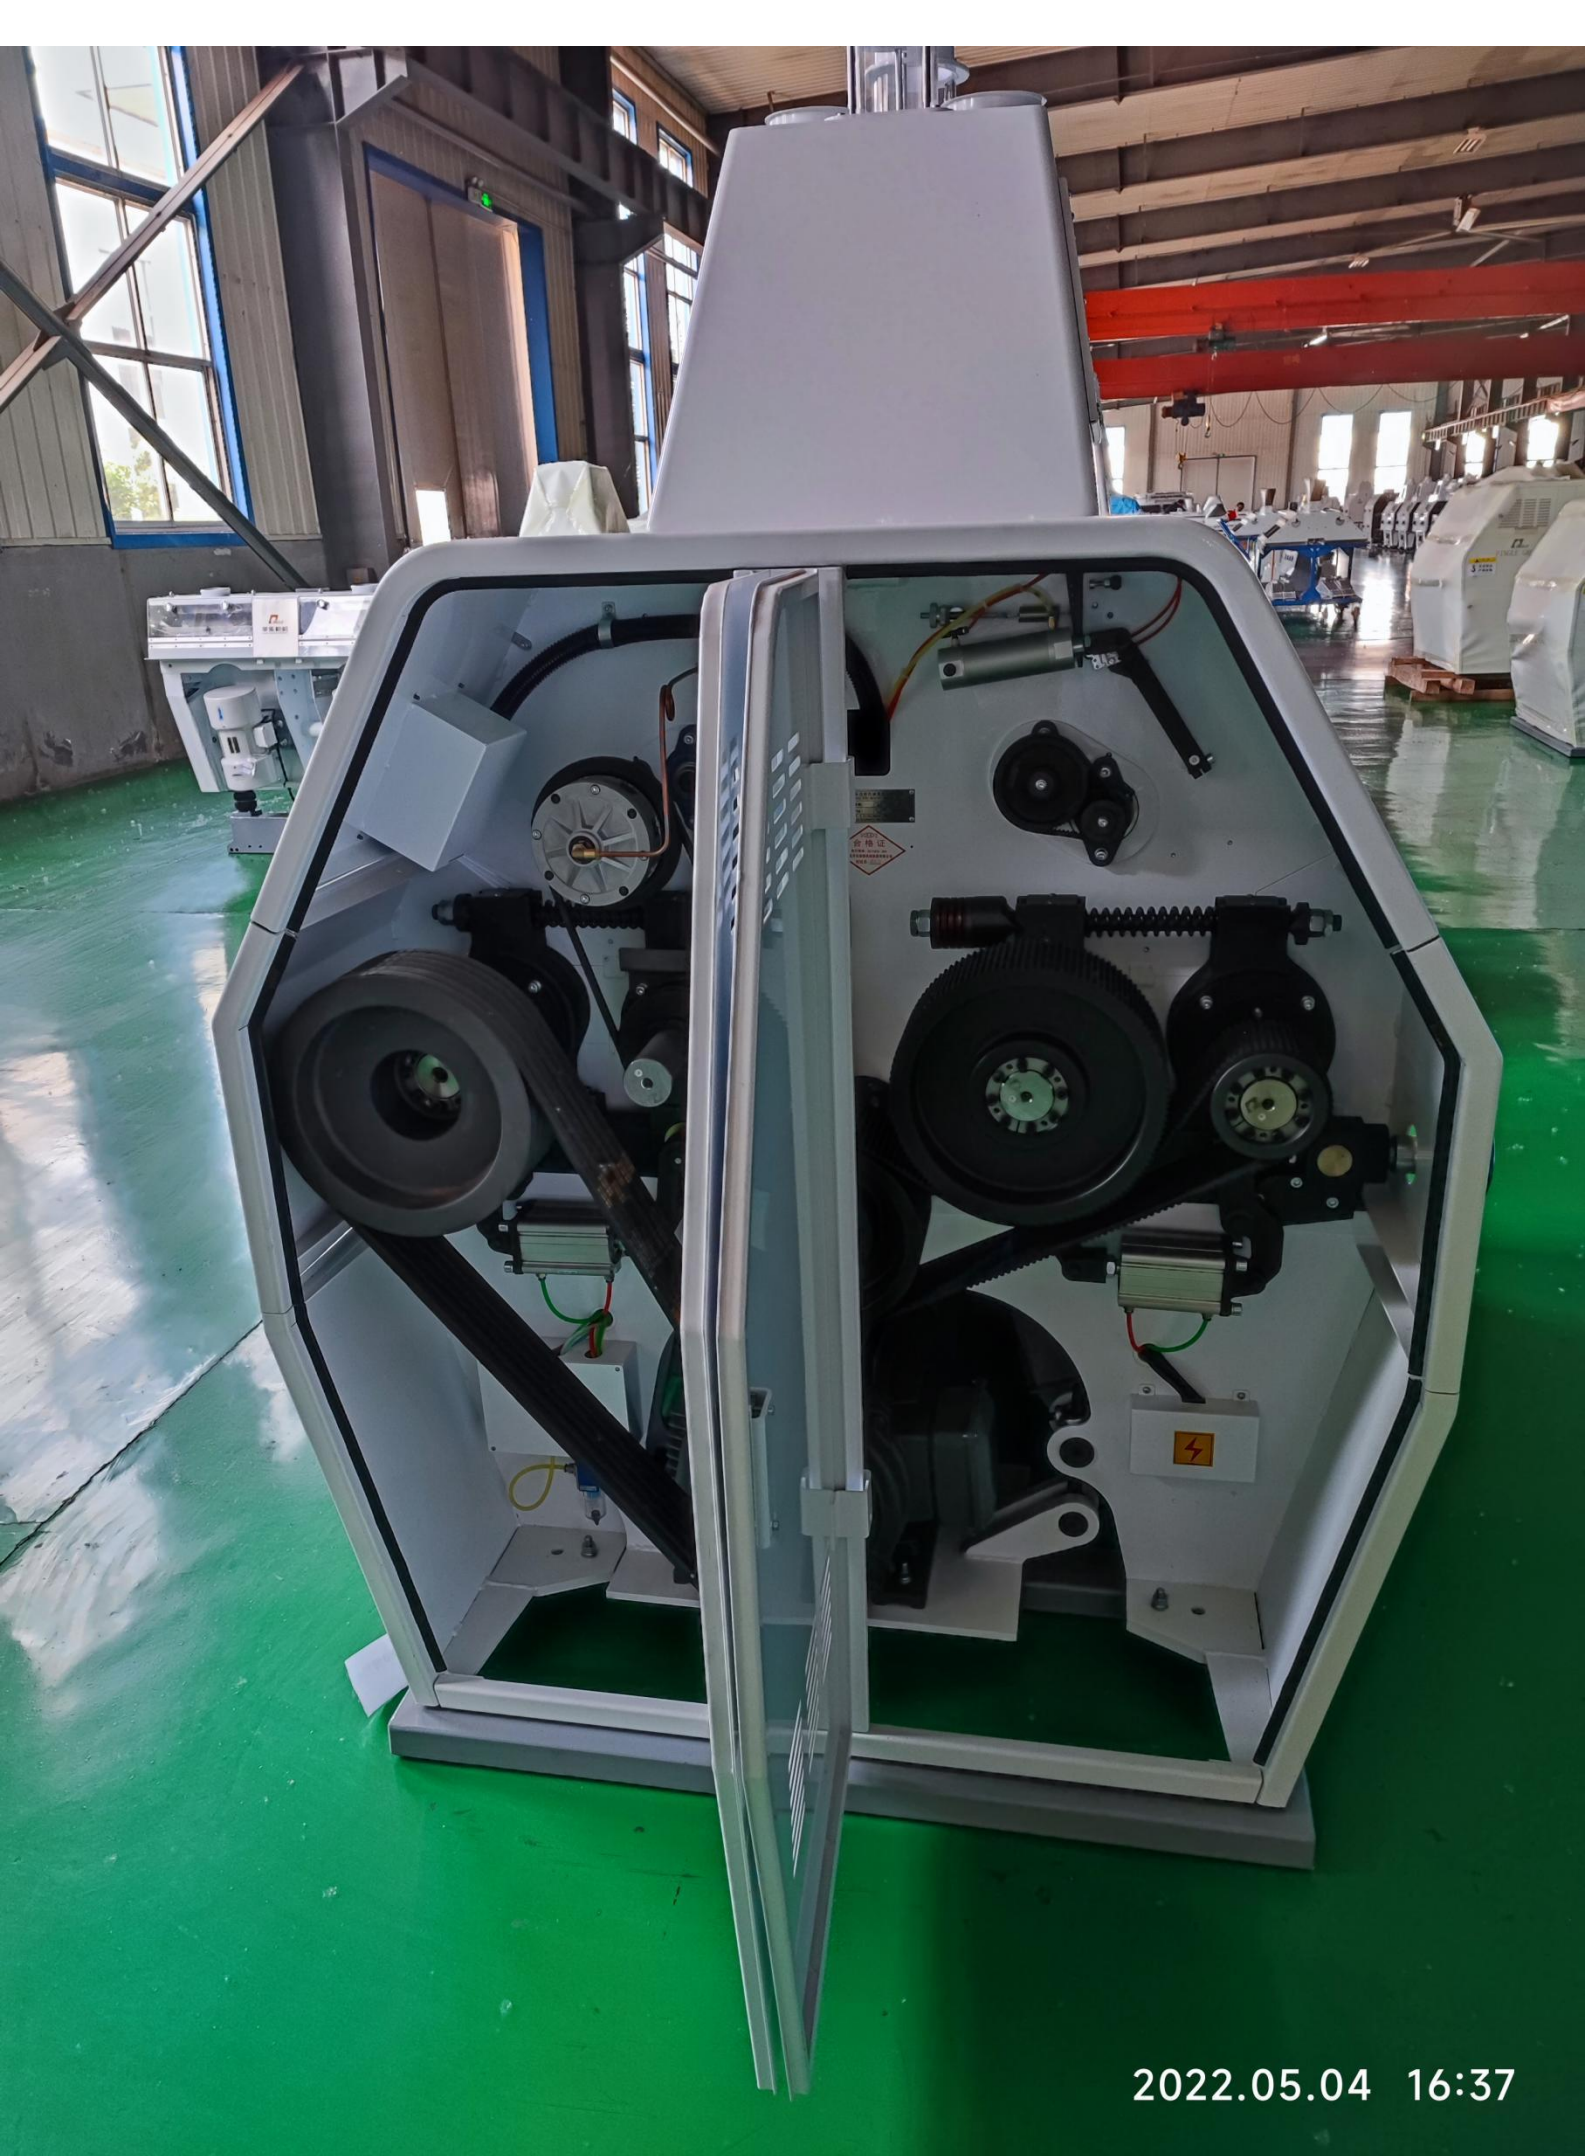

2022.05.04 16:37



2022.05.04 16:39



2022.05.04 16:38

